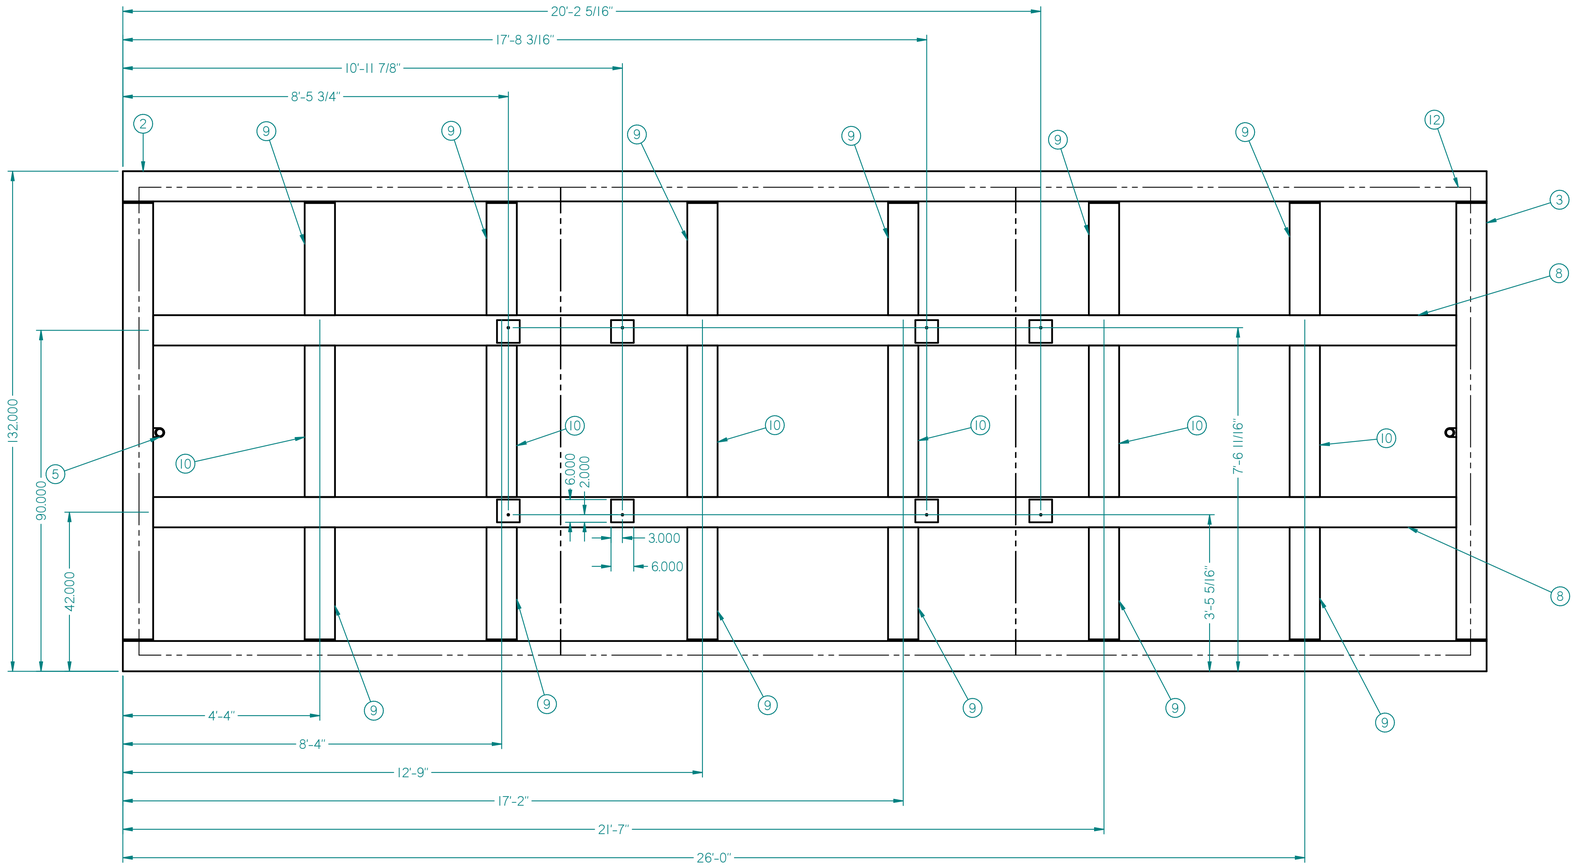


Item	Document Number	Title	Qty	Cut Length
2	W8-31	8" 31# WIDE FLANGE BEAM	2	360.000 in
3	W8-31	8" 31# WIDE FLANGE BEAM	2	123.534 in
4*	CPF16-CSTH3K	2" 3000# THREADED FULL COUPLING	2	
5	EL916-CSBWXH	2" XH BUTT WELD 90° LR ELBOW	2	
7*	H2HHN075Z	3/4-10 HEAVY HEX NUT	15	
8	W8-31	8" 31# WIDE FLANGE BEAM	2	351.720 in
9	W8-31	8" 31# WIDE FLANGE BEAM	12	37.625 in
10	W8-31	8" 31# WIDE FLANGE BEAM	6	47.715 in
11		1" THK BACKING PLATE FOR LIFTING LUGS	4	
12			2	
13*			1	
14*	11-0113	6" x 6" x 1" COMPRESSOR TANK MTG PADS	8	

ENGINEERING REVIEW

SELECT Engineering


- ☐ REVISE AND RESUBMIT
- ☐ REVIEWED, RELEASED FOR DETAIL DESIGN
- ☐ REVIEWED AS NOTED, RELEASED FOR DETAIL DESIGN
- ☑ REVIEWED, RELEASED FOR FABRICATION
- ☐ REVIEWED AS NOTED, RELEASED FOR FABRICATION


APPROVAL OF THESE DRAWINGS DOES NOT RELIEVE THE FABRICATOR OF RESPONSIBILITY FOR DIMENSIONAL ACCURACY, COMPLIANCE WITHT THE PURCHASE ORDER TERMS AND SPECIFICATIONS, AND COMPLIANCE WITH APPLICABLE CODES AND REGULATIONS.

BY jburton **DATE** 5/19/2026



DETAIL A

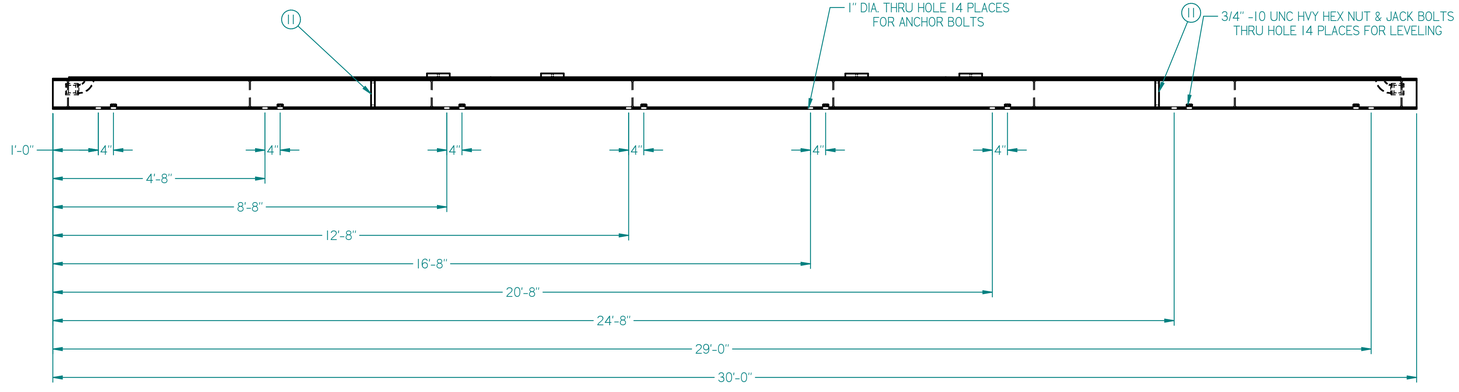

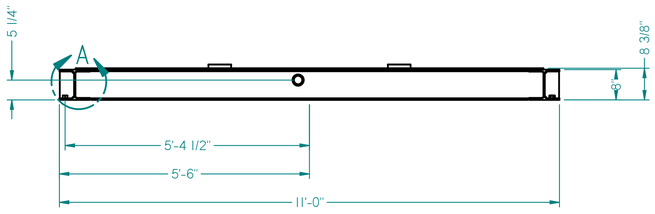

Tulsa, Ok.
Atlanta, Ga.

TESCORP

P.O. Box 471453
Tulsa,Oklahoma 74147

DATE:	SCALE:	DRAWN BY:	APPR'D:	REVISION
2-5-26		DB		01

SKID DETAIL DRAWING FOR ENCLOSED DUPLEX ATLAS COPCO GA110 IA PACKAGE

CUSTOMER:

DRAWING NUMBER: F-0126-0001B

DATE	REVISION DISCRIPTION	BY